
# TOSHIBA/HOUSTON

## DRIP-PROOF HORIZONTAL FOOT-MOUNTED

Fr. 364T-365T Fr. 364TS-365TS

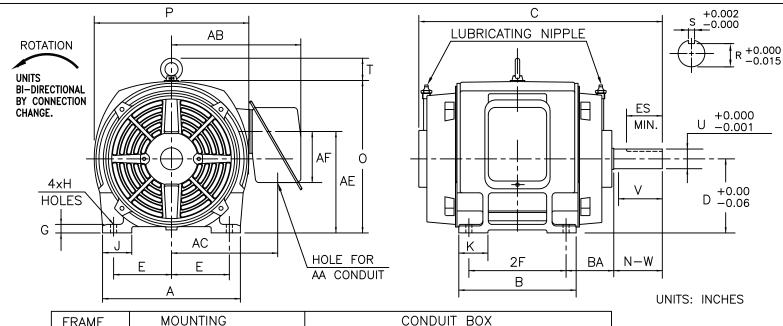

FRAME	М	OUNTIN	G				COND	UIT BO	X		
SIZE	Ε	2F	Ι	BA	AA	AB	AC	AE	AF	XL	XN
364T/TS	7.00	11.25	0.66	5.88	<u>3.0</u> ♠	14.81	12.24	12.1	6.3		
365T/TS	7.00	12.25	0.66	5.88	3.0 <del>2.36</del>	14.81	12.24	12.1	6.3		

FRAME					МОТО	R DIMEN	ISIONS				
SIZE	Α	В	С	D	G	J	K	М	0	Т	Ρ
364T	16.38	13.43	29.13	9.00	1.01	3.55	2.95		18.15	2.80	18.31
364TS	16.38	13.43	27.00	9.00	1.01	3.55	2.95		18.15	2.80	18.31
365T	16.38	14.41	30.13	9.00	1.01	3.55	2.95		18.15	2.80	18.31
365TS	16.38	14.41	28.00	9.00	1.01	3.55	2.95		18.15	2.80	18.31

FRAME	SHAFT EXTENSION			KEY SEAT			BEAF	MAXIMUM	
SIZE	N-W	V	U	R	S	ES	LS	OS	WEIGHT
364T	5.88	5.75	2.375	2.021	0.625	4.250	6314	6313 🕸	<del>516</del> 750 lbs.
364TS	3.75	3.50	1.875	1.591	0.500	2.000	6313C3	6313C3	<del>512</del> 745 lbs.
365T	5.88	5.75	2.375	2.021	0.625	4.250	6314	6313	<del>560</del> 838 lbs.
365TS	3.75	3.50	1.875	1.591	0.500	2.000	6313C3	6313C3	<del>565</del> 799 lbs.

ALL DATA SUBJECT TO CHANGE WITHOUT NOTICE. FOR CONSTRUCTION USE ONLY CERTIFIED DATA.

### CERTIFIED DATA

- DIMENSION V REPRESENTS LENGTH
   OF STRAIGHT PART OF SHAFT.
- OF STRAIGHT PART OF SHAFT.

  2. CONDUIT BOX MAY BE ROTATED
  IN 90' INCREMENTS AND MAY BE
  MOUNTED ON OPPOSITE SIDE ON
  SPECIAL ORDER.

  3. "T" KEY DIMENSIONS EQUAL S x S x 4.25
  "TS" KEY DIMENSIONS EQUAL S x S x 2.00
  (MOTOR SUPPLIED WITH KEY)

  4. MOTOR WEIGHT SHOWN IS MAXIMUM
  HORSEPOWER IN FRAME.

CUSTOMER:				
HP: 100 RPM (SYN.): 3600				
FRAME SIZE: 365TS  REMARKS:			LOG REV. LEVEL: _	
PER:	ISSUE DATE	:	SUPERSEDES:	SAS000928

#### TOSHIBA INTERNATIONAL CORPORATION

Industrial Division / Houston Motor Plant

INDEX	MPCF-1033
SHEET NO.	1 of 1
ISSUED	11/08/96
SUPERSEDES	10/06/95
REVISION	1
WRITTEN BY	R. EVANS
APPROVED BY	Jay Bugbee

# SQUIRREL CAGE INDUCTION MOTOR PERFORMANCE SPECIFICATIONS

Customer Tag:

CUSTOMER: TIC SR No.: Customer PO:

MOTOR NAMEPLATE DATA						
H.P.: 100	VOLTS: 575	3Ø/60	Hz	S. RPM: 3600		
FRAME: 365TS	ENCL: ODP	FLAMPS: 90.4		FLRPM: 3560		
FORM: VCK1	S.F.: 1.15	NEMA DESIGN: B		INSUL CLASS: F		
TYPE: TIKK	AMB.: 40C	CODE: H		DUTY: CONT.		
MODEL No.: 1002DPS0	C31B-P	kW: 75		Serial No.:		
NOM. EFF.: 93.6	MIN. EFF.:	P.F.:88.5				

AMPERAGE	TORQUES	** BEARINGS:
Locked Rotor: 696	FULL LOAD (lb-ft.): 148	Drive End: 6313C3
	LOCKED ROTOR (%): 175	Opposite Drive End: 6313C3
	BREAK DOWN (%): 270	

EFFICIENCY (%)	POWER FACTOR (%)
FULL LOAD: 93.6	FULL LOAD: 88.5
3/4 LOAD: 93.8	3/4 LOAD: 85.5
1/2 LOAD: 93.1	1/2 LOAD: 75.5

ALL CHARACTERISTICS ARE AVERAGE EXPECTED VALUES BASED UPON RATED VOLTAGE, FREQUENCY AND SINEWAVE POWER INPUT.

\* TEMPERATURE RISE WILL BE CONSISTENT WITH INSULATION, AMBIENT AND SERVICE FACTOR AS DEFINED BY NEMA-MG-12.43 OR -20.40.

\*\* BEARINGS ARE THE ONLY RECOMMENDED SPARE PART(S).

CERTIFIED BY: DATE:



Reliability in Motion

#### **TOSHIBA INTERNATIONAL CORPORATION**

INDUSTRIAL DIVISION PO BOX 40906 HOUSTON TX 77240 (713) 466-0277

(800) 231-1412 FAX (713) 466-8773

#### **SPARE PARTS (RECOMMENDED)**

OTHER THAN THE GREASE USED FOR RE-GREASABLE BEARINGS, TOSHIBA ADVISES THAT THERE ARE NO "USE" PARTS. THE ONLY INSURANCE SPARES THAT TOSHIBA SUGGESTS FOR THESE SQUIRREL CAGE INDUCTION MOTORS ARE INDUSTRY STANDARD, AND COMMERCIALLY AVAILABLE ANTI-FRICTION BEARINGS, AS NOTED BELOW.

MOTOR COMPONENTS (SUCH AS TERMINAL BOXES, FAN COVERS, MACHINED PARTS) ARE AVAILABLE UPON SPECIAL REQUEST. IN THIS CASE, PLEASE ADVISE OUR ORDER ENTRY DEPARTMENT THE MODEL AND SERIAL NUMBERS (FOUND ON THE MOTOR NAMEPLATE), AND A DESCRIPTION OF THE COMPONENT REQUIRED. THEY WILL THEN FURNISH THE CURRENT PART NUMBER, PRICE AND AVAILABILITY.

(NOTE: OUR INTERNAL PART NUMBERS ARE SUBJECT TO CHANGE WITHOUT NOTICE, AND ARE NOT PUBLISHED).

PLEASE ADVISE IF YOU HAVE ANY QUESTIONS.

CUSTOMER:
PURCHASE ORDER #
Customer Tag:

TOSHIBA FILE #

MODEL # 1002DPSC31B-P

HP/RPM/ENCL/FRAME: 100 / 3600 / ODP / 365TS

DRIVE END BEARING: 6313C3
OPPOSITE DRIVE END BEARING: 6313C3

Prepared By: Date: