
# TOSHIBA/HOUSTON

## DRIP-PROOF HORIZONTAL FOOT-MOUNTED

Fr. 404T-405T Fr. 404TS-405TS

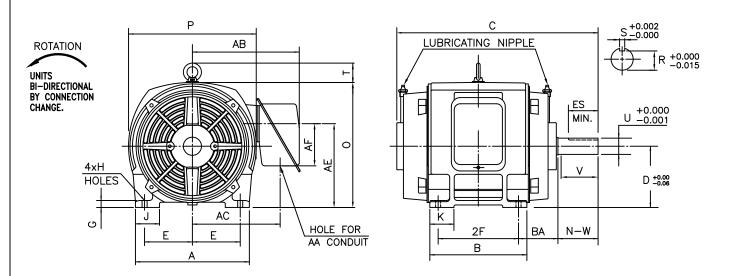

**FRAME MOUNTING** CONDUIT BOX SIZE 2F ВА AΒ AC ΑE ΑF XLXN AΑ 4.0 404T/TS 8.00 12.25 0.81 6.62 20.08 15.08 12.95 8.66 4.0 <del>4.64</del> 405T/TS 8.00 13.75 0.81 6.62 20.08 15.08 | 12.95 8.66

UNITS: INCHES

FRAME	MOTOR DIMENSIONS										
SIZE	Α	В	O	D	G	J	K	М	0	Τ	Ρ
404T	19.69	14.96	33.10	10.00	1.03	3.94	4.13		20.24	3.54	20.24
404TS	19.69	14.96	30.10	10.00	1.03	3.94	4.13		20.24	3.54	20.24
405T	19.69	16.54	34.60	10.00	1.03	3.94	4.13		20.24	3.54	20.24
405TS	19.69	16.54	31.60	10.00	1.03	3.94	4.13		20.24	3.54	20.24

FRAME	SHAFT EXTENSION			KEY SEAT		BEARINGS		MAXIMUM	
SIZE	N-W	V	U	R	S	ES	LS	0S	
404T	7.25	7.00	2.875	2.450	0.750	5.65	6317	6313	<del>1010</del> 1090 lbs.
404TS	4.25	4.00	2.125	1.845	0.500	2.78	6313C3	6313C3	<del>1010</del> 1068 lbs.
405T	7.25	7.00	2.875	2.450	0.750	5.65	6317	6313	<del>1146</del> 1172 lbs.
405TS	4.25	4.00	2.125	1.845	0.500	2.78	6313C3	6313C3	<del>1124</del> 1161 lbs.

ALL DATA SUBJECT TO CHANGE WITHOUT NOTICE. FOR CONSTRUCTION USE ONLY CERTIFIED DATA.

## CERTIFIED DATA

#### NOTES:

- NOTES:

  1. DIMENSION V REPRESENTS LENGTH
  OF STRAIGHT PART OF SHAFT.

  2. CONDUIT BOX MAY BE ROTATED
  IN 90' INCREMENTS AND MAY BE
  MOUNTED ON OPPOSITE SIDE ON
  SPECIAL ORDER.

  3. "T" KEY DIMENSIONS EQUAL S x S x 5.63
  "TS" KEY DIMENSIONS EQUAL S x S x 2.76
  (MOTOR SUPPLIED WITH KEY)

  A MOTOR SUPPLIED WITH KEY)
- 4. MOTOR WEIGHT SHOWN IS MAXIMUM HORSEPOWER IN FRAME.

CUSTOMER:		
HP: 100 RPM (SYN.): 1800 FRAME SIZE: 404T LO	 VOLTAGE: <u>230/460</u>	_ Hz:60
REMARKS:		SAS003528

### TOSHIBA INTERNATIONAL CORPORATION

Industrial Division / Houston Motor Plant

INDEX	MPCF-1033		
SHEET NO.	1 of 1		
ISSUED	11/08/96		
SUPERSEDES	10/06/95		
REVISION	1		
WRITTEN BY	R. EVANS		
APPROVED BY	Jay Bugbee		

# SQUIRREL CAGE INDUCTION MOTOR PERFORMANCE SPECIFICATIONS

Customer Tag:

CUSTOMER: TIC SR No.: Customer PO:

MOTOR NAMEPLATE DATA					
H.P.: 100	VOLTS: 230/460	3Ø/60	Hz	S. RPM: 1800	
FRAME: 404T	ENCL: ODP	FLAMPS: 230/1	15	FLRPM: 1775	
FORM: VBK1	S.F.: 1.15	NEMA DESIGN: B		INSUL CLASS: F	
TYPE: TIKK	AMB.: 40C	CODE: G		DUTY: CONT.	
MODEL No.: 1004DPSA31A-P		kW: 75		Serial No.:	
NOM. EFF.: 95.4	MIN. EFF.:	P.F.:84.5			

AMPERAGE	TORQUES	** BEARINGS:
Locked Rotor: 725	FULL LOAD (lb-ft.): 296 LOCKED ROTOR (%): 190 BREAK DOWN (%): 235	Drive End: 6317 Opposite Drive End: 6313
	LOCKED ROTOR (%): 190	

EFFICIENCY (%)	POWER FACTOR (%)
FULL LOAD: 95.4	FULL LOAD: 84.5
3/4 LOAD: 95.7	3/4 LOAD: 81.5
1/2 LOAD: 95.4	1/2 LOAD: 74

ALL CHARACTERISTICS ARE AVERAGE EXPECTED VALUES BASED UPON RATED VOLTAGE, FREQUENCY AND SINEWAVE POWER INPUT.

\* TEMPERATURE RISE WILL BE CONSISTENT WITH INSULATION, AMBIENT AND SERVICE FACTOR AS DEFINED BY NEMA-MG-12.43 OR -20.40.

\*\* BEARINGS ARE THE ONLY RECOMMENDED SPARE PART(S).

CERTIFIED BY: DATE:



Reliability in Motion

#### **TOSHIBA INTERNATIONAL CORPORATION**

INDUSTRIAL DIVISION
PO BOX 40906
HOUSTON TX 77240 (80
(713) 466-0277 FA

(800) 231-1412 FAX (713) 466-8773

#### **SPARE PARTS (RECOMMENDED)**

OTHER THAN THE GREASE USED FOR RE-GREASABLE BEARINGS, TOSHIBA ADVISES THAT THERE ARE NO "USE" PARTS. THE ONLY INSURANCE SPARES THAT TOSHIBA SUGGESTS FOR THESE SQUIRREL CAGE INDUCTION MOTORS ARE INDUSTRY STANDARD, AND COMMERCIALLY AVAILABLE ANTI-FRICTION BEARINGS, AS NOTED BELOW.

MOTOR COMPONENTS (SUCH AS TERMINAL BOXES, FAN COVERS, MACHINED PARTS) ARE AVAILABLE UPON SPECIAL REQUEST. IN THIS CASE, PLEASE ADVISE OUR ORDER ENTRY DEPARTMENT THE MODEL AND SERIAL NUMBERS (FOUND ON THE MOTOR NAMEPLATE), AND A DESCRIPTION OF THE COMPONENT REQUIRED. THEY WILL THEN FURNISH THE CURRENT PART NUMBER, PRICE AND AVAILABILITY.

(NOTE: OUR INTERNAL PART NUMBERS ARE SUBJECT TO CHANGE WITHOUT NOTICE, AND ARE NOT PUBLISHED).

PLEASE ADVISE IF YOU HAVE ANY QUESTIONS.

CUSTOMER:
PURCHASE ORDER #
Customer Tag:

TOSHIBA FILE #

MODEL # 1004DPSA31A-P

HP / RPM / ENCL / FRAME: 100 / 1800 / ODP / 404T

DRIVE END BEARING: 6317 OPPOSITE DRIVE END BEARING: 6313

> Prepared By: Date: