
# TOSHIBA/HOUSTON

## DRIP-PROOF HORIZONTAL FOOT-MOUNTED

Fr. 447T-449T Fr. 447TS-449TS

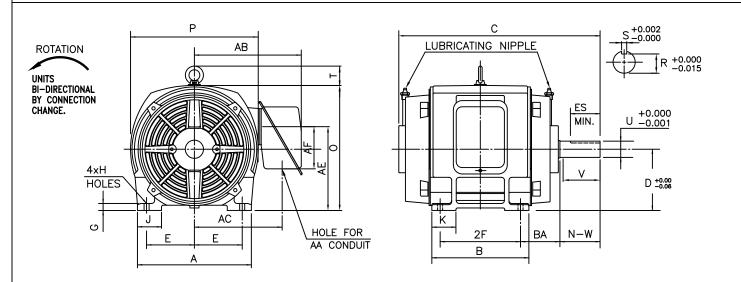

UNITS: INCHES

FRAME	FRAME MOUNTING			CONDUIT BOX							
SIZE	Ε	2F	Ι	BA	AA	AB	AC	ΑE	AF	XL	XN
447T/TS	9.00	20.00	0.81	7.50	4.0 A	20.86	15.98	14.15	8.66		
449T/TS	9.00	25.00	0.81	7.50	4.0 <del>4.84</del>	20.86	15.98	14.15	8.66		

FRAME					МОТО	R DIMEN	ISIONS				
SIZE	Α	В	С	D	G	J	К	М	0	Т	Р
447T	22.05	22.83	43.20	11.00	1.18	4.33	4.72	-	22.81	3.54	22.05
447TS	22.05	22.83	39.45	11.00	1.18	4.33	4.72		22.81	3.54	22.05
449T	22.05	27.83	49.77	11.00	1.18	4.33	4.72		22.81	3.54	22.05
449TS	22.05	22.83	46.02	11.00	1.18	4.33	4.72		22.81	3.54	22.05

FRAME	SHAFT EXTENSION			r	KEY SEAT		BEARINGS		. MAXIMUM
SIZE	N-W	V	U	R	S	ES	LS	0S	⚠ WEIGHT
447T	8.50	8.25	3.375	2.880	0.875	6.91	<b>∆</b> 6318	6318	<del>1887</del> 2100 lbs.
447TS	4.75	4.50	2.375	2.021	0.625	3.03	6313C3	6313C3	<del>1938</del> 2100 lbs.
449T	8.50	8.25	3.375	2.880	0.875	6.91	<b>∆</b> 6318	6318	2300 lbs.
449TS	4.75	4.50	2.375	2.021	0.625	3.03	6313C3	6313C3	2150 lbs.

ALL DATA SUBJECT TO CHANGE WITHOUT NOTICE. FOR CONSTRUCTION USE ONLY CERTIFIED DATA.

### CERTIFIED DATA

- NOTES:

  1. DIMENSION V REPRESENTS LENGTH
  OF STRAIGHT PART OF SHAFT.

  2. CONDUIT BOX MAY BE ROTATED
  IN 90' INCREMENTS AND MAY BE
  MOUNTED ON OPPOSITE SIDE ON
  SPECIAL ORDER.

  3. "T" KEY DIMENSIONS EQUAL S x S x 6.89
  "TS" KEY DIMENSIONS EQUAL S x S x 3.03
  (MOTOR SUPPLIED WITH KEY)

  A MOTOR SUPPLIED WITH KEY)
- 4. MOTOR WEIGHT SHOWN IS MAXIMUM HORSEPOWER IN FRAME.

CUSTOMER:				
HP: <u>150</u> RPM (SYN.): <u>1200</u>	)	_VOLTAGE: _ <b>575</b>		Hz: <u>60</u>
FRAME SIZE: 447T L			REV. LEVEL:	
PER:	ISSUE DATE:		_ SUPERSEDES:	SAS010115

#### TOSHIBA INTERNATIONAL CORPORATION

Industrial Division / Houston Motor Plant

INDEX	MPCF-1033
SHEET NO.	1 of 1
ISSUED	11/08/96
SUPERSEDES	10/06/95
REVISION	1
WRITTEN BY	R. EVANS
APPROVED BY	Jay Bugbee

# SQUIRREL CAGE INDUCTION MOTOR PERFORMANCE SPECIFICATIONS

Customer Tag:

CUSTOMER: TIC SR No.: Customer PO:

MOTOR NAMEPLATE DATA					
H.P.: 150	VOLTS: 575	3 Ø / 60	Hz	S. RPM: 1200	
FRAME: 447T	ENCL: ODP	FLAMPS: 143.2		FLRPM: 1185	
FORM: VBK1	S.F.: 1.15	NEMA DESIGN: B		INSUL CLASS: F	
TYPE: TIKK	AMB.: 40C	CODE: G		DUTY: CONT.	
MODEL No.: 1506DPSC31A-P		kW: 110		Serial No.:	
NOM. EFF.: 95.4	MIN. EFF.:	P.F.:81.5			

AMPERAGE	TORQUES	** BEARINGS:
Locked Rotor: 868	FULL LOAD (lb-ft.): 665	Drive End: 6318
	LOCKED ROTOR (%): 175 BREAK DOWN (%): 200	Opposite Drive End: 6318
	, ,	

EFFICIENCY (%)	POWER FACTOR (%)
FULL LOAD: 95.4	FULL LOAD: 81.5
3/4 LOAD: 95.8	3/4 LOAD: 78.5
1/2 LOAD: 95.9	1/2 LOAD: 71.5

ALL CHARACTERISTICS ARE AVERAGE EXPECTED VALUES BASED UPON RATED VOLTAGE, FREQUENCY AND SINEWAVE POWER INPUT.

\* TEMPERATURE RISE WILL BE CONSISTENT WITH INSULATION, AMBIENT AND SERVICE FACTOR AS DEFINED BY NEMA-MG-12.43 OR -20.40.

\*\* BEARINGS ARE THE ONLY RECOMMENDED SPARE PART(S).

CERTIFIED BY: DATE:



Reliability in Motion

#### **TOSHIBA INTERNATIONAL CORPORATION**

INDUSTRIAL DIVISION
PO BOX 40906
HOUSTON TX 77240 (8
(713) 466-0277 FA

(800) 231-1412 FAX (713) 466-8773

#### **SPARE PARTS (RECOMMENDED)**

OTHER THAN THE GREASE USED FOR RE-GREASABLE BEARINGS, TOSHIBA ADVISES THAT THERE ARE NO "USE" PARTS. THE ONLY INSURANCE SPARES THAT TOSHIBA SUGGESTS FOR THESE SQUIRREL CAGE INDUCTION MOTORS ARE INDUSTRY STANDARD, AND COMMERCIALLY AVAILABLE ANTI-FRICTION BEARINGS, AS NOTED BELOW.

MOTOR COMPONENTS (SUCH AS TERMINAL BOXES, FAN COVERS, MACHINED PARTS) ARE AVAILABLE UPON SPECIAL REQUEST. IN THIS CASE, PLEASE ADVISE OUR ORDER ENTRY DEPARTMENT THE MODEL AND SERIAL NUMBERS (FOUND ON THE MOTOR NAMEPLATE), AND A DESCRIPTION OF THE COMPONENT REQUIRED. THEY WILL THEN FURNISH THE CURRENT PART NUMBER, PRICE AND AVAILABILITY.

(NOTE: OUR INTERNAL PART NUMBERS ARE SUBJECT TO CHANGE WITHOUT NOTICE, AND ARE NOT PUBLISHED).

PLEASE ADVISE IF YOU HAVE ANY QUESTIONS.

CUSTOMER:
PURCHASE ORDER #
Customer Tag:

TOSHIBA FILE #

MODEL # 1506DPSC31A-P

HP / RPM / ENCL / FRAME: 150 / 1200 / ODP / 447T

DRIVE END BEARING: 6318
OPPOSITE DRIVE END BEARING: 6318

Prepared By: Date: